


LEGEND
 - - - - - TO BE WIRED BY OTHERS
 ∅ WDU TERMINALS
 ⊗ SPADE CONNECTOR
WIRE COLOURS & SIZES
 POWER WIRES COLOUR CODED
 CONTROL WIRES 2.5MM2 BLK PH. MARKED
 24VAC - RED ACTIVE - BLACK - NEUTRAL
 12VAC - WHITE
 WIRES TO BE NUMBERED (GRAFOPLAST)

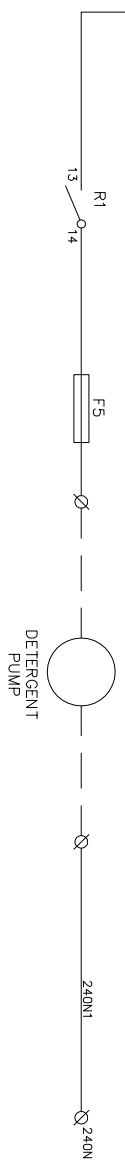

TO NO. 11
 TERMINAL
 TO NO. 10
 TERMINAL
 TO NO. 13
 TERMINAL

NOTES

REV	BY	DATE	DESCRIPTION	CHECKED	APPROVED	DATE
A	CV	21.03.18	AS BUILT	GT	GT	21.03.18

THIS DRAWING IS COPYRIGHT OF AUCORUS SOLUTIONS AND MUST NOT BE COPIED OR REPRODUCED IN ANY MANNER WITHOUT THE WRITTEN PERMISSION.
 JET BLASTER
 FOAM CAR WASH
 CONTROL PANEL
 PAGE 1 OF 1

DESIGNED	DRAWN	CHECKED	ENG. APPR.	PROJ. APPR.

APPROVALS
 CLIENT: XXXXX
 TITLE: XXXXX
 SCALE: NTS.
 JOB NO: 256
 DRAWING NO: 3SB-43/AUS 10-SP/02-65-3000

SHEET SIZE	REV
A3	0

